

BRIDGETON LANDFILL QUARTERLY INFRASTRUCTURE SUBMITTAL

**BRIDGETON LANDFILL, LLC
13570 ST. CHARLES ROCK ROAD
BRIDGETON, MISSOURI 63044**

INDEX OF DRAWINGS	
	TITLE PAGE
001	SITE INFRASTRUCTURE PLAN (FULL COLOR)
002	SITE INFRASTRUCTURE PLAN
003	SITE INFRASTRUCTURE PLAN - GRIDS A,B,C,D
004	SITE INFRASTRUCTURE PLAN - GRID A
005	SITE INFRASTRUCTURE PLAN - GRID B
006	SITE INFRASTRUCTURE PLAN - GRID C
007	SITE INFRASTRUCTURE PLAN - GRID D



406 EAST WALNUT STREET
CHATHAM, IL 62629
TEL. (217) 483-3118
FAX. (217) 483-2356

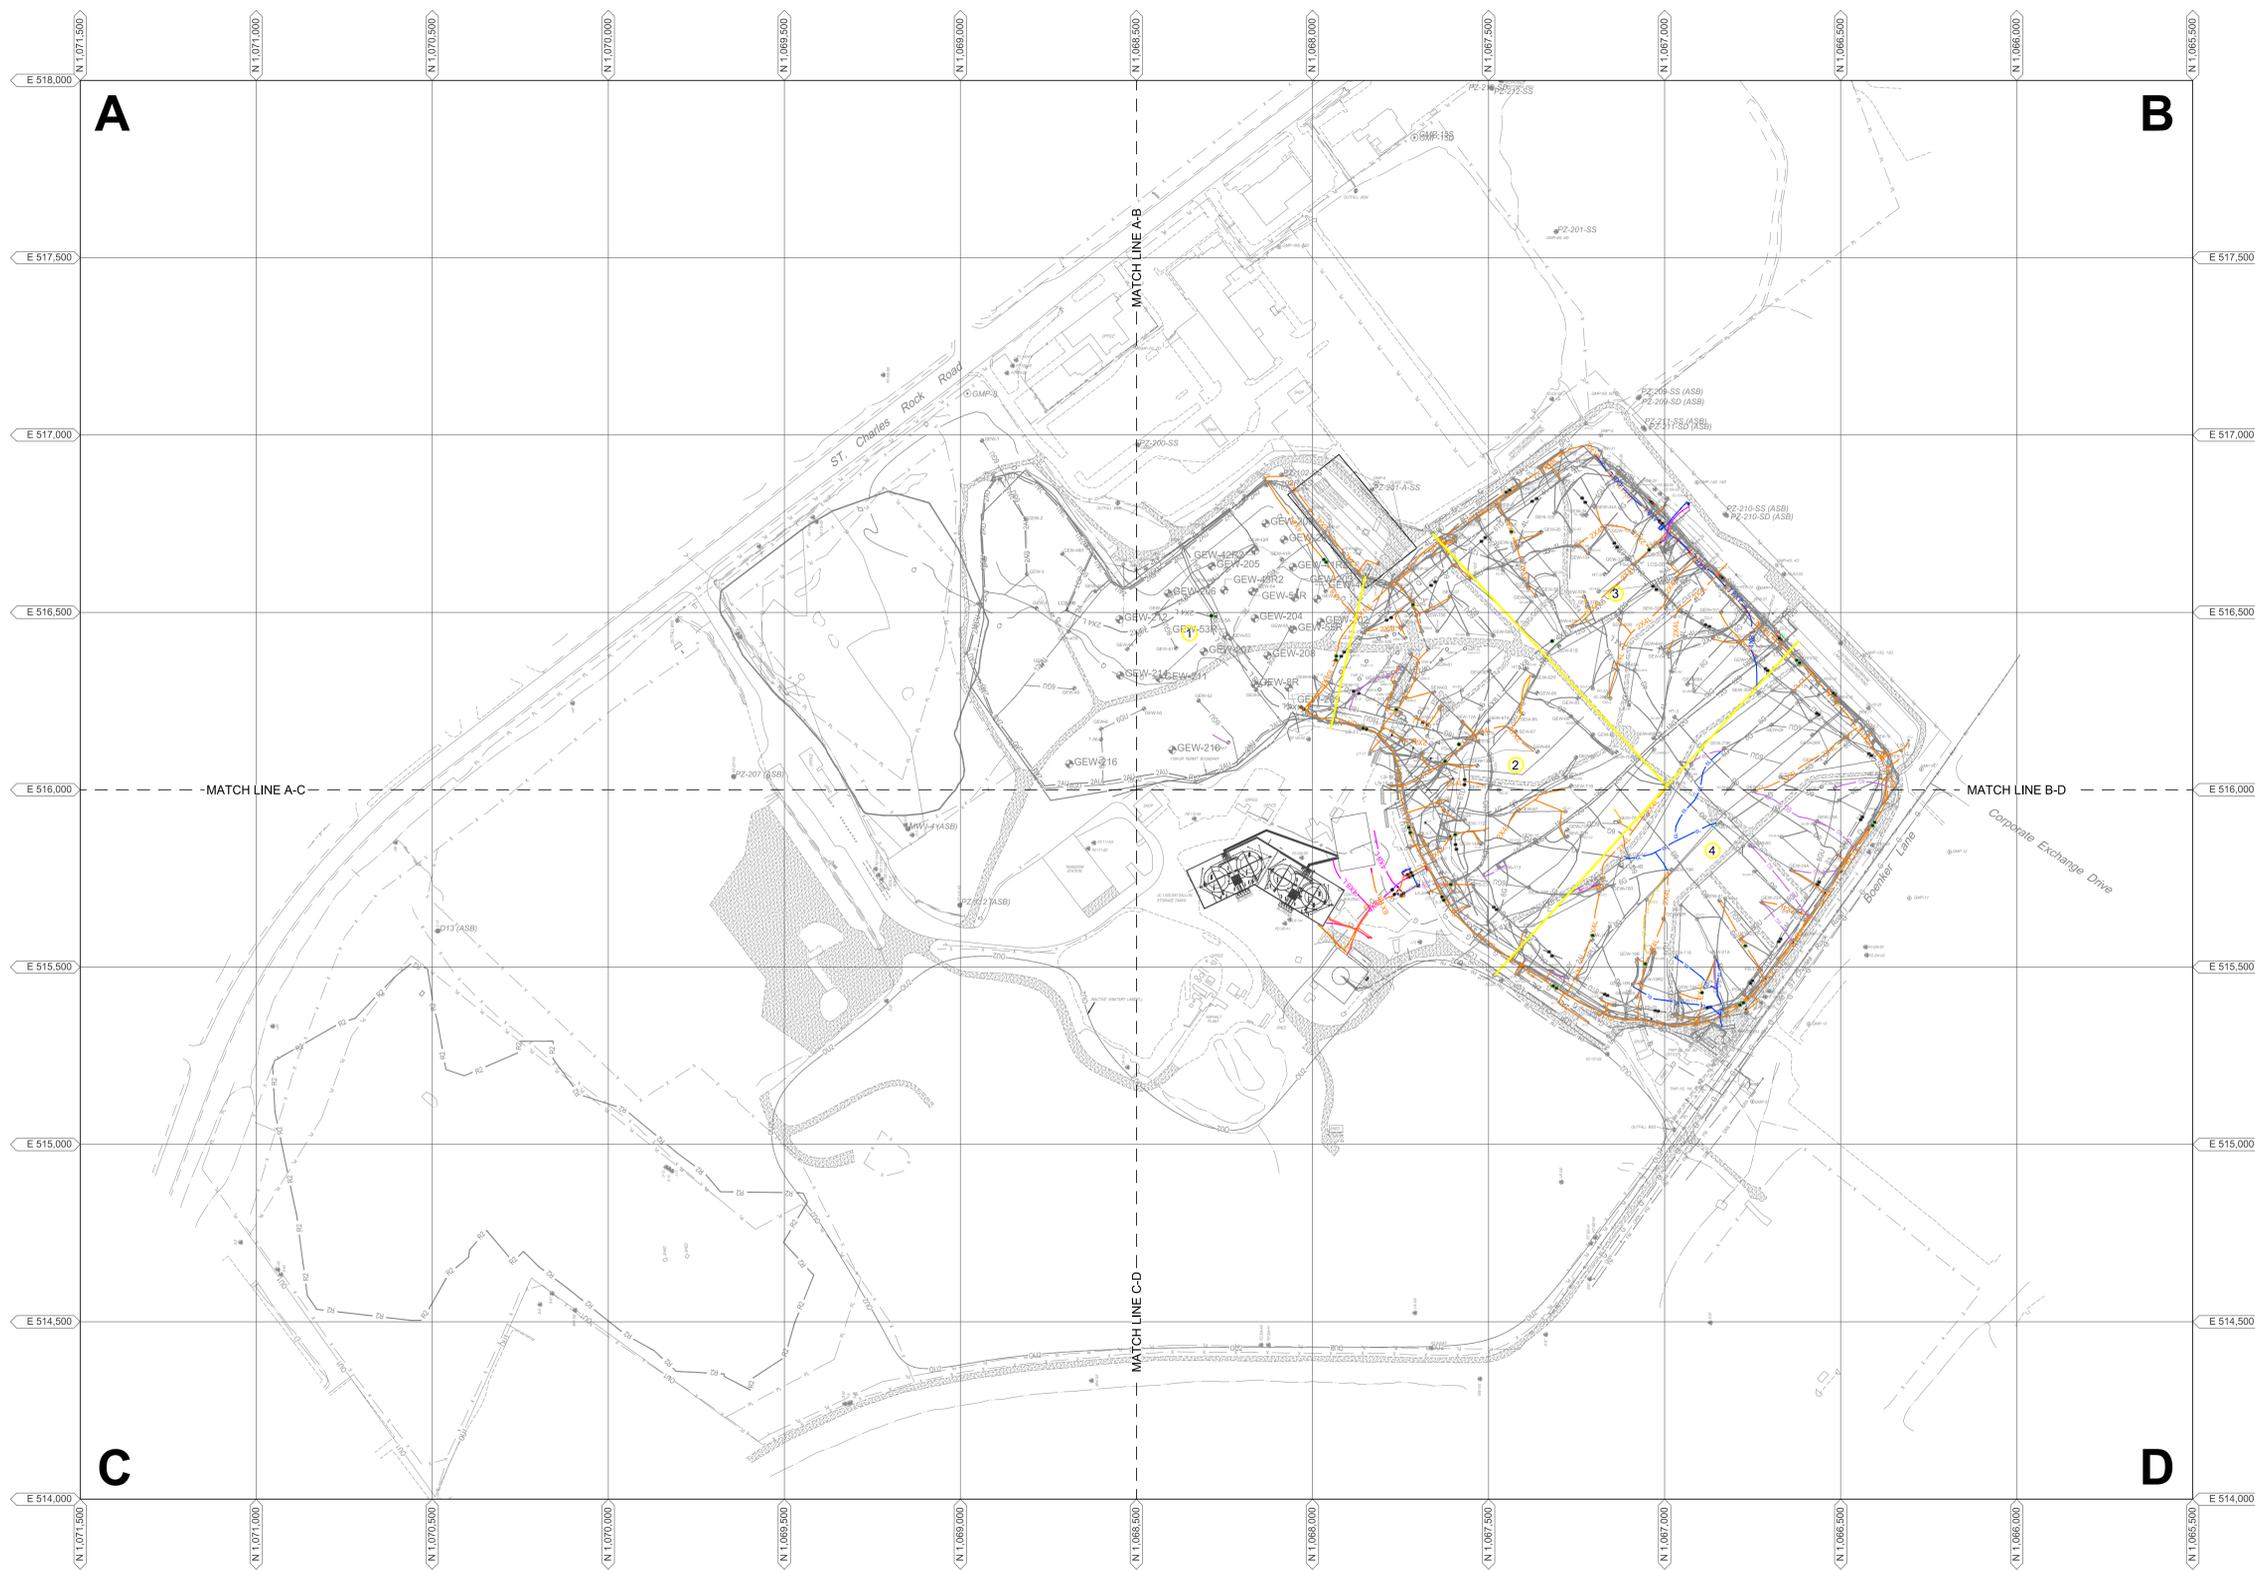


- LEGEND**
- SOLID WASTE BOUNDARY
 - GAS MONITORING PROBE
 - PIEZOMETER MONITORING WELL
 - GAS EXTRACTION WELL
 - DUAL GAS EXTRACTION WELL
 - SURFACE EXTRACTION WELL
 - PERIMETER GAS EXTRACTION WELL
 - LFG ISOLATION VALVE
 - LEACHATE ISOLATION VALVE
 - FLOW METER
 - GRIT CHAMBER
 - LIFT STATION
 - CONDENSATE SUMP
 - LEACHATE COLLECTION SUMP
 - HORIZONTAL COLLECTION SUMP
 - PERIMETER SUMP
 - LEACHATE COLLECTION SUMP
 - SURFACE COLLECTOR
 - TEMPERATURE MONITORING PROBE
 - SUBSURFACE RCP WELLS
 - TRENCH SUMP
 - INTERCEPTION TRENCH RISER
 - PERIMETER LEACHATE SUMP
 - WELL HEAD RISER
 - WELL BORE BOOT
 - TRENCH SUMP
 - OVER LINER TIE IN POINT
 - GAS INTERCEPTOR WELL
 - CLEAN OUT
 - QUADRANT #
 - QUARRY WALL
 - BURIED LFG COLLECTION PIPING
 - 2" ABOVE GROUND LFG COLLECTION PIPING
 - 4" ABOVE GROUND LFG COLLECTION PIPING
 - 6" ABOVE GROUND LFG COLLECTION PIPING
 - 8" ABOVE GROUND LFG COLLECTION PIPING
 - 10" STEEL GROUND LFG COLLECTION PIPING
 - 12" ABOVE GROUND LFG COLLECTION PIPING
 - 18" ABOVE GROUND LFG COLLECTION PIPING
 - FENCE LINE
 - AIR LINE
 - AIR LINE (PRESSURIZED BELOW GROUND)
 - LEACHATE COLLECTION PIPING
 - DUAL CONTAINED LCS FORCEMAIN
 - DUAL CONTAINED PERIMETER FORCEMAIN
 - ARTESIAN LIQUID PIPING
 - UNDERGROUND ELECTRIC LINE
 - NATURAL GAS LINE
 - WATERMAIN
 - BUBBLE SUCKER
 - TOE DRAIN
 - 4" PERFORATED TRENCH DRAIN
 - INTERCEPTION TRENCH
 - BUILDING




NOTE: SEVERAL SIGNIFICANT PROJECTS ARE CURRENTLY UNDER CONSTRUCTION AT SITE. AS-BUILTS TO BE SUBMITTED UPON COMPLETION AND CERTIFICATION.

BRIDGETON LANDFILL, LLC 13070 ST. CHARLES ROCK ROAD BRIDGETON, MISSOURI 63044	BRIDGETON LANDFILL FIRST QUARTER 2014 - SITE INFRASTRUCTURE	APRIL 2014 DESIGNED BY: PML APPROVED BY: ---	DRAWING NO.: 003
SITE INFRASTRUCTURE PLAN - GRIDS A,B,C,D		FEZZOR ENGINEERING, INC.	
PROJECT NUMBER: BT-023 FILE PATH: C:\Users\pml\Documents\Bridgton\BT-023\GIS\2014-04\Site Infrastructure\003 - SIFP-01.dwg			

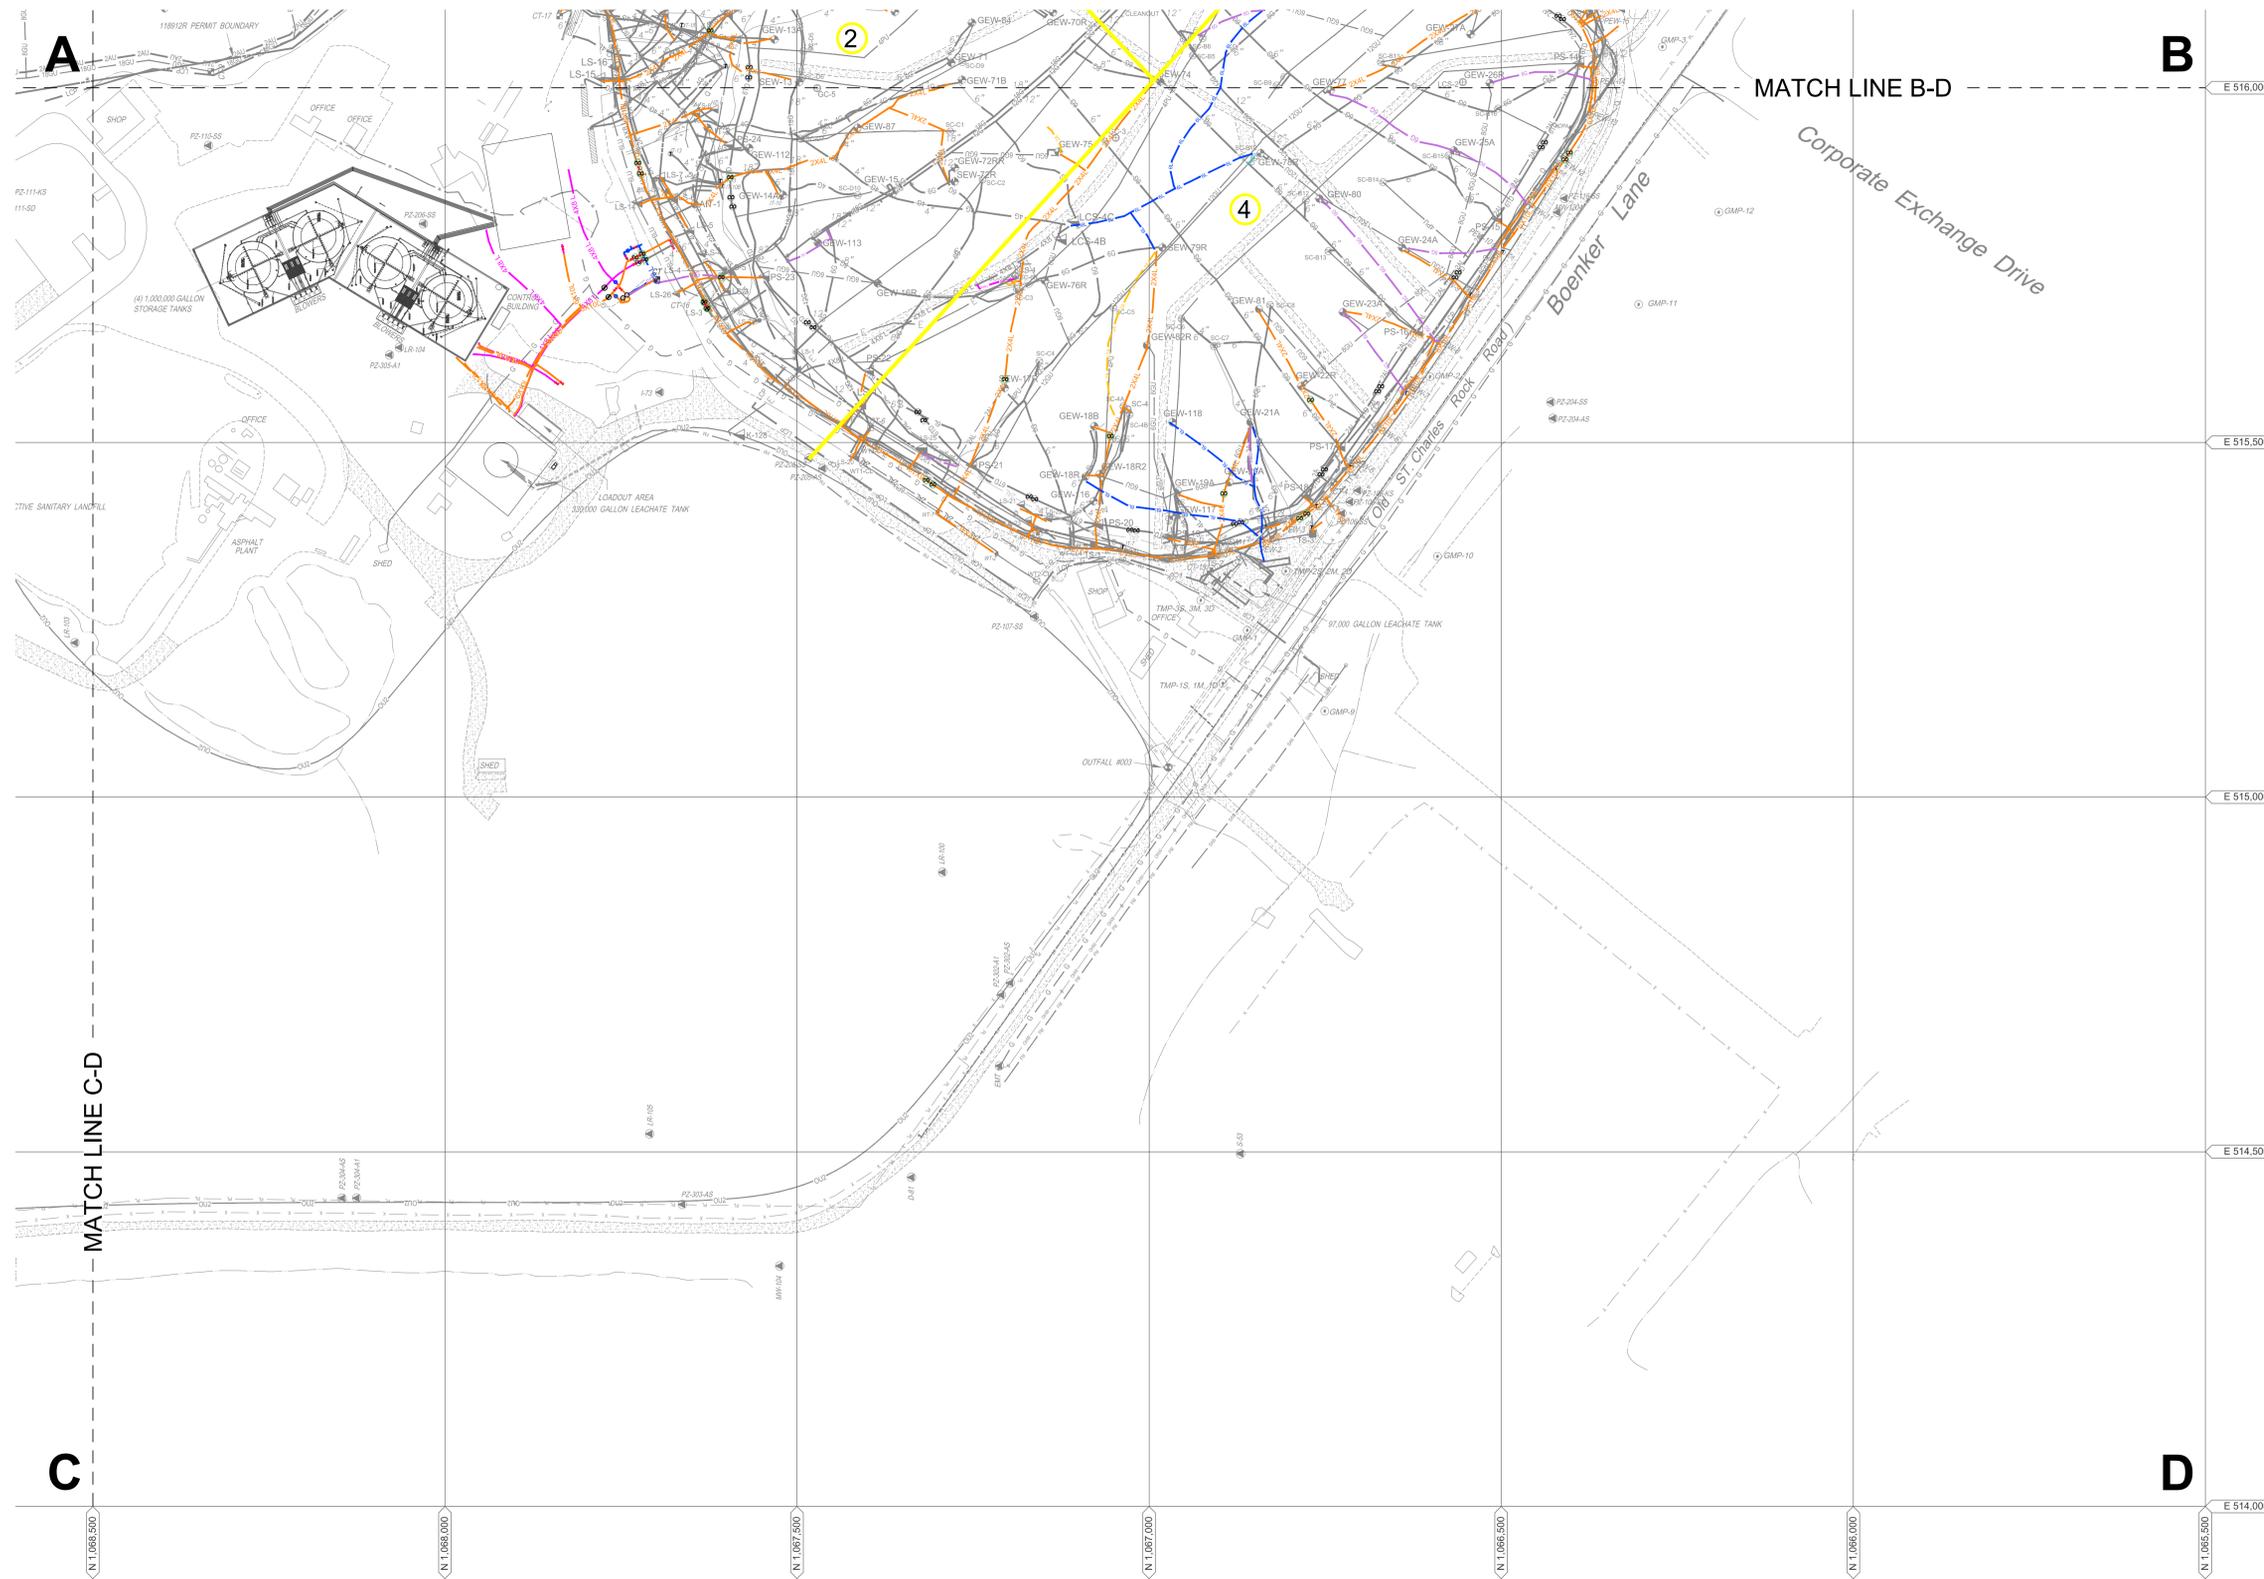

- LEGEND**
- SOLID WASTE BOUNDARY
 - GAS MONITORING PROBE
 - PIEZOMETER MONITORING WELL
 - GAS EXTRACTION WELL
 - DUAL GAS EXTRACTION WELL
 - SURFACE EXTRACTION WELL
 - PERIMETER GAS EXTRACTION WELL
 - LFG ISOLATION VALVE
 - LEACHATE ISOLATION VALVE
 - FLOW METER
 - GRIT CHAMBER
 - LIFT STATION
 - CONDENSATE SUMP
 - LEACHATE COLLECTION SUMP
 - HORIZONTAL COLLECTION SUMP
 - PERIMETER SUMP
 - LEACHATE COLLECTION SUMP
 - SURFACE COLLECTOR
 - TEMPERATURE MONITORING PROBE
 - SUBSURFACE RCP WELLS
 - TRENCH SUMP
 - INTERCEPTION TRENCH RISER
 - PERIMETER LEACHATE SUMP
 - WELL HEAD RISER
 - WELL BORE BOOT
 - TRENCH SUMP
 - OVER LINER TIE IN POINT
 - GAS INTERCEPTOR WELL
 - CLEAN OUT
 - QUARRY WALL
 - BURIED LFG COLLECTION PIPING
 - 2" ABOVE GROUND LFG COLLECTION PIPING
 - 4" ABOVE GROUND LFG COLLECTION PIPING
 - 6" ABOVE GROUND LFG COLLECTION PIPING
 - 8" ABOVE GROUND LFG COLLECTION PIPING
 - 10" STEEL GROUND LFG COLLECTION PIPING
 - 12" ABOVE GROUND LFG COLLECTION PIPING
 - 18" ABOVE GROUND LFG COLLECTION PIPING
 - FENCE LINE
 - AIR LINE
 - AIR LINE (PRESSURIZED BELOW GROUND)
 - LEACHATE COLLECTION PIPING
 - DUAL CONTAINED LCS FORCE MAIN
 - DUAL CONTAINED PERIMETER FORCE MAIN
 - ARTESIAN LIQUID PIPING
 - UNDERGROUND ELECTRIC LINE
 - NATURAL GAS LINE
 - WATERMAIN
 - BUBBLE SUCKER
 - TOE DRAIN
 - 4" PERFORATED TRENCH DRAIN
 - INTERCEPTION TRENCH
 - BUILDING

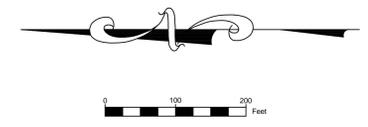

NOTE: SEVERAL SIGNIFICANT PROJECTS ARE CURRENTLY UNDER CONSTRUCTION AT SITE. AS-BUILTS TO BE SUBMITTED UPON COMPLETION AND CERTIFICATION.

BRIDGETON LANDFILL, LLC 13070 ST. CHARLES ROCK ROAD BRIDGETON, MISSOURI 63044	BRIDGETON LANDFILL FIRST QUARTER 2014 - SITE INFRASTRUCTURE	APRIL 2014 DESIGNED BY: PML APPROVED BY: ...	DRAWING NO.: 007
SITE INFRASTRUCTURE PLAN - GRID D			
PROJECT NUMBER: BT-023 FILE PATH: C:\Users\pml\Documents\Bridgton\BT-023\GIS\Infrastructure\2014-04\007_Site_Infrastructure_Grid_D.dwg			