GLM - A2 Lake

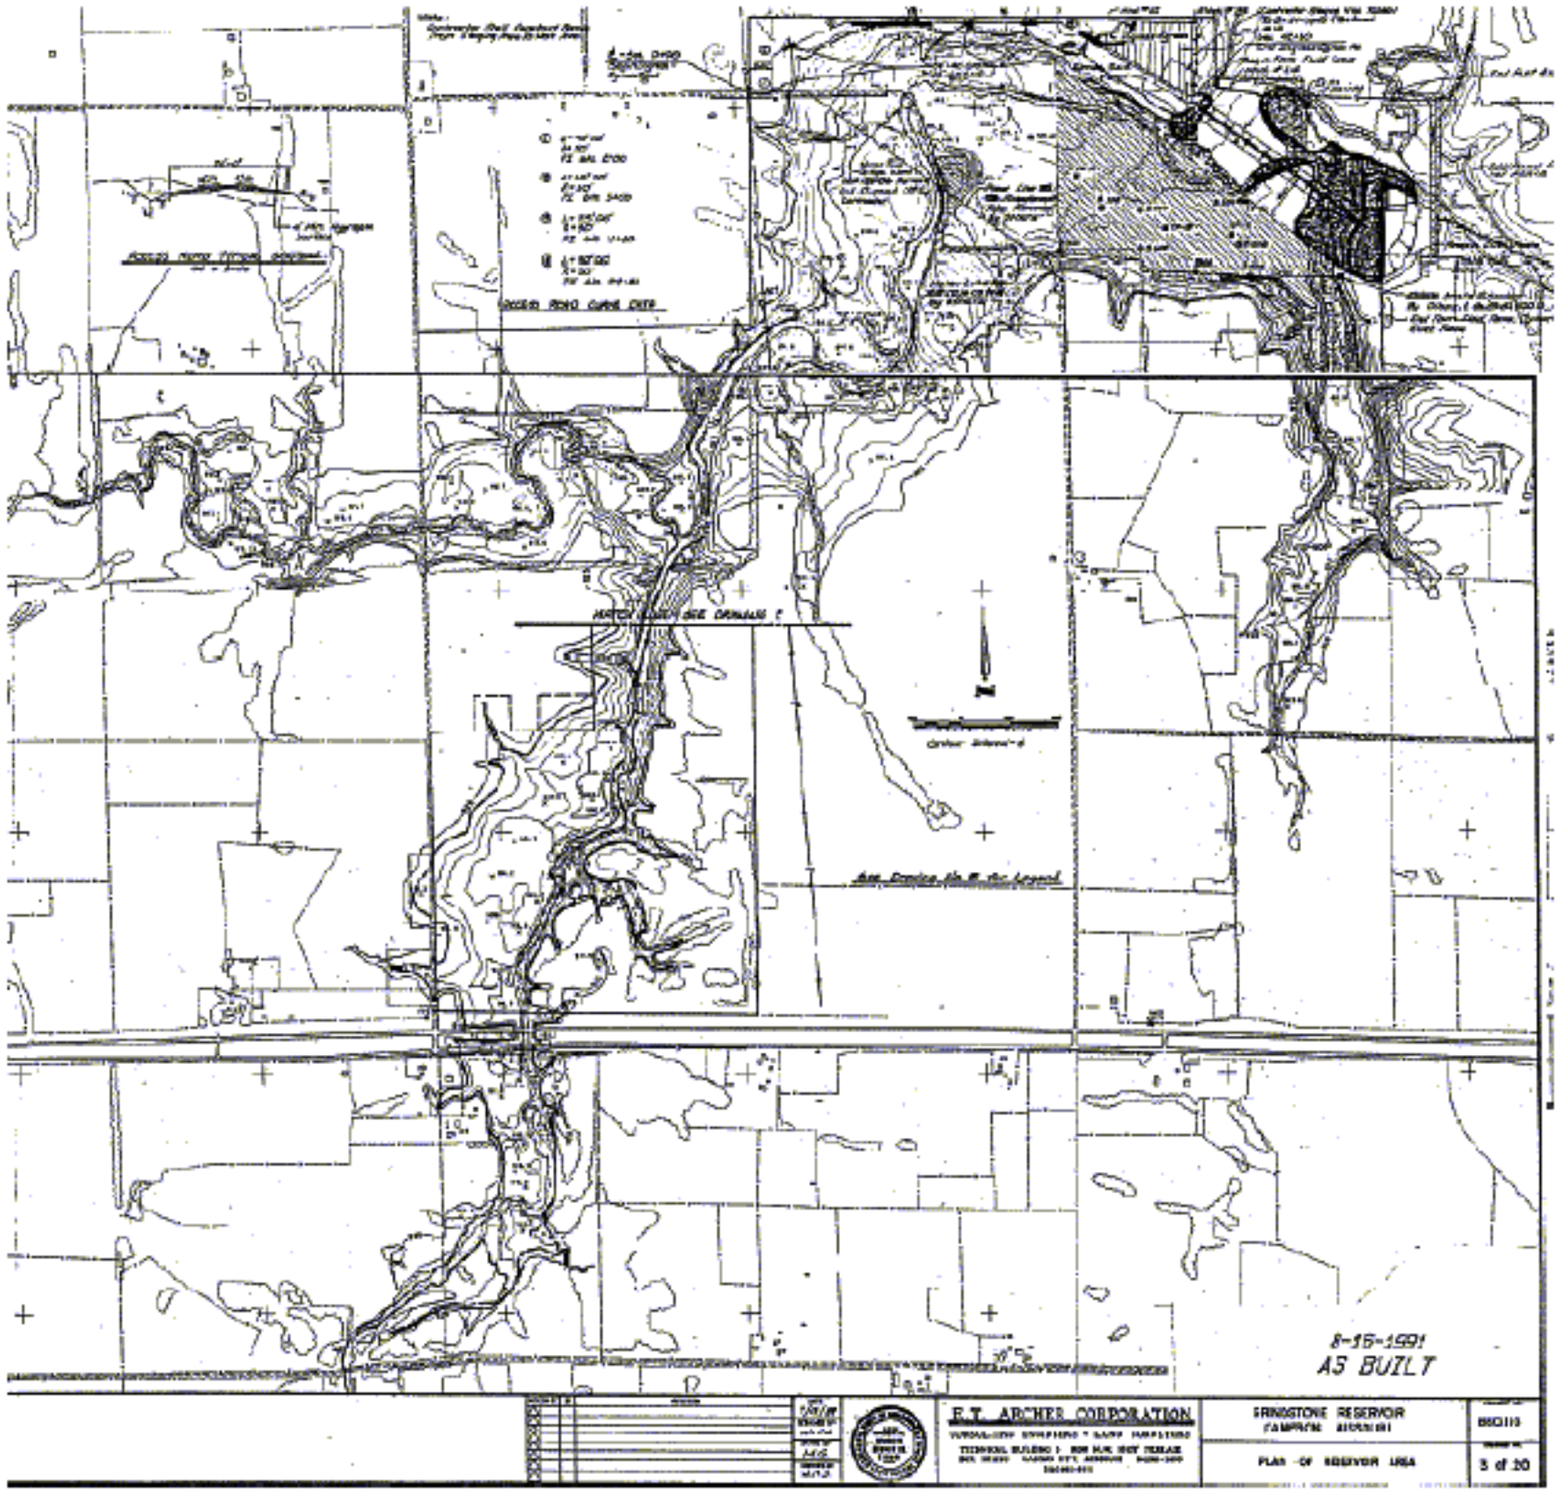
8-16-1991
AS BUILT
E.T. ARCHER CORPORATION
FRINGSTONE RESERVOIR
PLAN OF RESERVOIR AREA
3 of 20